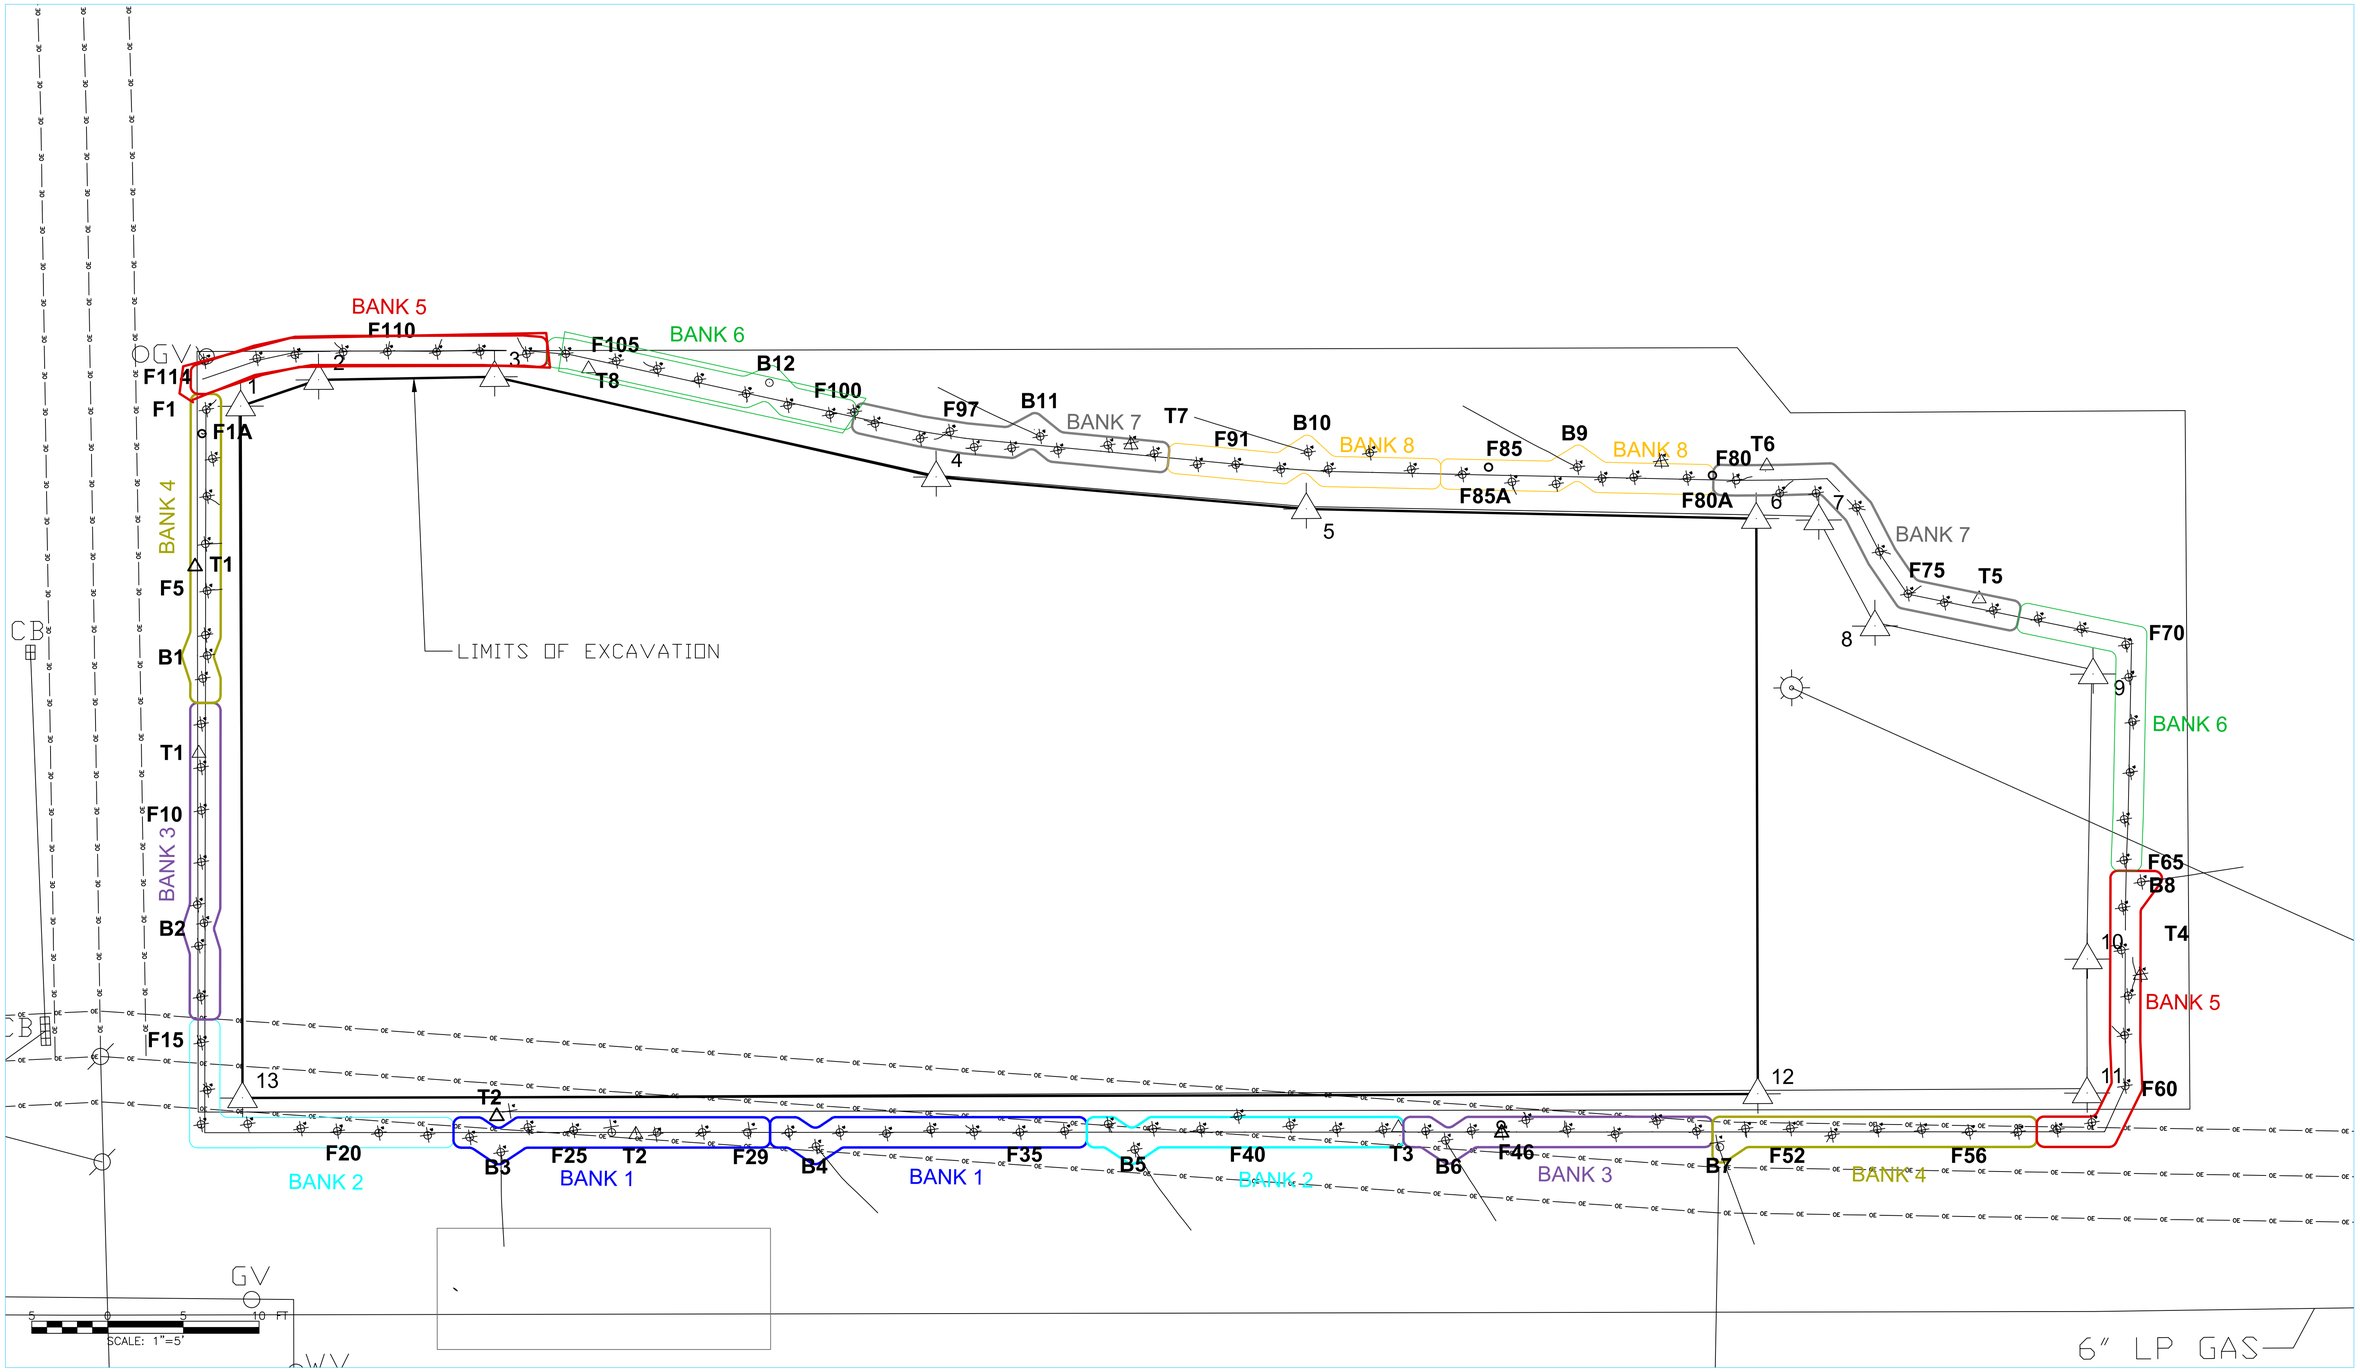
BANK 5
F110
F105
BANK 6
B12
F100
F97
B11
BANK 7
T7
F91
B10
BANK 8
F85
B9
BANK 8
F80
T6
F85A
F80A
BANK 7
F75
T5
F70
BANK 6
F65
B8
T4
BANK 5
F60
OGV
F114
F1
F1A
BANK 4
T1
F5
B1
T1
F10
BANK 3
B2
F15
CB
LIMITS OF EXCAVATION
T2
F20
BANK 2
B3
F25
BANK 1
T2
F29
B4
F35
BANK 1
B5
F40
BANK 2
T3
B6
F46
BANK 3
B7
F52
BANK 4
F56
GV
SCALE: 1"=5'
6" LP GAS